Development Services

2406 Leopard Street, Corpus Christi, TX 78408

Date: 07-24-2025 11:34:16



<u>Final Report - Approved</u>

Application No. PL8810

Description : Address :

Record Type: PLAT

Document Filename : 250613 PLAT.R1.pdf

Comment Author Contact Information:

Author Name	Author Email	Author Phone No.:
Mark Zans	markz2@cctexas.com	361-826-3553
Alex Harmon	alexh2@cctexas.com	361-826-1102

General Comments

Comment ID	Author : Department	Status	Review Comments
4	Alex Harmon : DS	Closed	Improvements Required for Recordation, per UDC 8.1.4. A. Streets: No Sidewalks: No B. Water: No Fire hydrants: No C. Wastewater: No D. Stormwater: No E. Public open space: No F. Permanent monument markers: No Please note, improvements required should be constructed to city standards, found in Article 8 and the IDM.

Corrections in the following table need to be applied before a permit can be issued

Comment ID	0	Annotation Type	Author : Department	Status	Review Comments
5	P002	Note	Alex Harmon : DS	Closed	7/16/25 UPDATE: Comment not addressed. Plat has zone AE (10 ft) and Zone AE (11 ft). Utility Plan has zone AE (11 ft) only. Confirm BFEs and
					ensure consistency.
6	P002	Note	Mark Zans : LD	Closed	Place square footages of lots on the lots.

Comment ID	Page Reference	Annotation Type	Author : Department	Status	Review Comments
7	P002	Note	Mark Zans : LD	Closed	Make plat outline a heavier darker line width. make it distinctive from the other plat lines.
8	P002	Note	Mark Zans : LD	Closed	Park fee: 3 residential units x 462.50 = \$1,387.50
9	P002	Note	Mark Zans : LD	Closed	: Plat is a (Non-public notice PC plat).
10	P002	Note	Mark Zans : LD	Closed	
11	P002	Note	Mark Zans : LD	Closed	The plat will be recommended as Conditional Approval for Resolution comments received and that have remained Open and unmet.
12	P002	Note	Mark Zans : LD	Closed	: A request or response may be made for an additional 30 days for Public Notice plat with a Waiver or to res olve Open comments. This request must be made directly to Development Services within the 30-day initial period.

STATE OF TEXAS COUNTY OF NUECES

REGISTERED PROFESSIONAL LAND SURVEYOR


LICENSE NO. 4854

WE. WILLIAM WILSON and 4 WS, LLCC., HEREBY CERTIFIES THAT WE ARE THE OWNERS OF THE LANDS EMBRACED WITHIN THE BOUNDARIES OF THE FORGOING PLAT; THAT IT HAS HAD SAID LAND SURVEYED AND SUBDIVIDED AS SHOWN; THAT STREETS AS SHOWN ARE DEDICATED TO THE PUBLIC FOREVER; THAT ALL EASEMENTS ARE DEDICATED TO THE PUBLIC FOR THE INSTALLATION,

PADRE ISLAND NO 2, BLOCK 43 LOTS 14A, 15A AND 15B

BEING A RE-PLAT OF PADRE ISLAND NO 2, BLOCK 43 LOT 14 and LOT 15 ACCORDING TO THE

OPERATION, AND USE OF PUBLIC UTILITIES; THAT THIS MAP WAS MADE FOR THE PURPOSE OF MAP RECORDED IN VOLUME 13, PAGE 28, MAP RECORDS OF NUECES COUNTY, TEXAS. DESCRIPTION AND DEDICATION. THIS THE_____ DAY OF _____ 2025. WILLIAM WILSON, OWNER AND MANAGER OF 4 WS. LLC PADRE ISLAND NUMBER 2 VOLUME 13, PAGE 28 M.R.N.C.T. LOT 13 — BLOCK 43 PADRE ISLAND NUMBER 2 STATE OF TEXAS FOUND 5/8" I.R. (RED CAP) COUNTY OF NUECES VOLUME 13, PAGE 28 M.R.N.C.T. THIS INSTRUMENT WAS ACKNOWLEDGED BEFORE ME BY WILLIAM WILSON. PACKERS CHANNEL THIS THE_____ DAY OF _____ 2025. ZONE AE BFE 10.0 FT. NOTARY PUBLIC IN AND FOR THE STATE OF TEXAS SET 5/8" I.R. LOT 14A 0.51 Acres. ZONE AE FOUND 5/8" I.R. (YELLOW CAP) BFE 11.0 FT. 22,216 Sq. Ft. FOUND 5/8" I.R. STATE OF TEXAS SET 5/8" I.R. COUNTY OF NUECES LOT 15A 0.51 Acres. THIS FINAL PLAT OF THE HEREIN DESCRIBED PROPERTY WAS 22,7 Sq. Ft. APPROVED BY THE PLANNING COMMISSION ON BEHALF OF THE CITY OF CORPUS CHRISTI, TEXAS. THIS THE_____ DAY OF _____ 2025. MICHAEL YORK, CHAIRMAN DUND 1/2" I.P. FOUND 5/8" I.R. LOT 15B MICHAEL DICE, SECRETARY , REY (50) 0.51 Acres. 22,216 Sq. Ft. STATE OF TEXAS COUNTY OF NUECES THIS FINAL PLAT OF THE HEREIN DESCRIBED PROPERTY WAS APPROVED BY THE DEVELOPMENT SERVICES ENGINEER OF THE CITY OF CORPUS CHRISTI, TEXAS. FOUND 5/8" I.R. LOT 16 - BLOCK 43 PADRE ISLAND NUMBER 2 THIS THE_____ DAY OF _____ 2025. BRIA WHITMIRE, P.E. CFM. CPM DEVELOPMENT SERVICES ENGINEER STATE OF TEXAS COUNTY OF NUECES , JARREL L. MOORE, A REGISTERED PROFESSIONAL LAND SURVEYOR HEREBY CERTIFY THAT THE FOREGOING PLAT WAS PREPARED FROM A SURVEY MADE ON THE GROUND UNDER MY DIRECTION AND IS TRUE AND CORRECT; THAT I HAVE BEEN ENGAGED UNDER CONTRACT TO SET ALL LOT AND BLOCK CORNERS AND COMPLETE SUCH OPERATIONS WITHOUT DELAY. THIS THE ____ DAY OF _____ 2025.

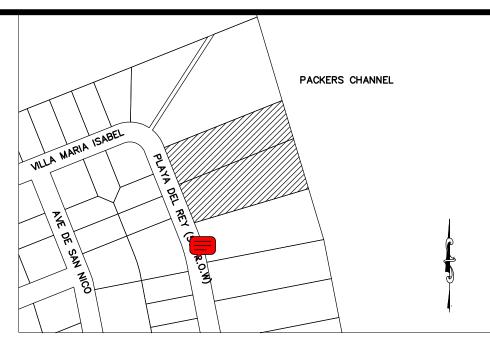

LOCATION MAP NOT TO SCALE


GENERAL NOTES:

- 1) THE TOTAL PLATTED AREA CONTAINS 1.53 ACRES OF LAND.
- 2) A 5/8" DIAMETER STEEL REBAR WAS SET AT EVERY CORNER, EXCEPT OTHERWISE SPECIFIED.
- 3) THE YARD REQUIREMENT, AS DEPICTED IS A REQUIREMENT OF THE UNIFIED DEVELOPMENT CODE AND IS SUBJECT TO CHANGE AS THE ZONING MAY CHANGE.
- 4) PER FLOOD INSURANCE RATE MAP, MAP INDEX, COMMUNITY-PANEL NUMBER 48355C0565G, MAP REVISED 10/13/2022, THE SUBJECT PROPERTY IS LOCATED IN ZONE X AREAS OF 0.2 ANNUAL PERCENTAGENFLOOD HAZARD AND ZONE AE AREAS OF SPECIAL FLOOD HAZARD WITH BFE OF 10 FT AND 11 FT
- 5) ALL BEARINGS REFER TO THE TEXAS STATE PLANE COORDINATE SYSTEM OF 1983, TEXAS SOUTH ZONE.
- 6) THE RECEIVING WATER FOR THE STORM WATER RUNOFF FROM THIS PROPERTY IS THE LAGUNA MADRE BASIN. THE TCEQ HAS CLASSIFED THE AQUATIC LIFE USE FOR THE LAGUNA MADRE AS "EXCEPTIONAL" AND "OYSTER WATERS". TCEQ ALSO CATEGORIZED THE LAGUNA MADRE AS "CONTACT RECREATION" USE.
- 7) PROPOSED DRIVEWAY ACCESS TO A PUBLIC CITY STREET SHALL CONFORM TO ACCESS MANAGEMENT STANDARDS OUTLINED IN ARTICLE 7 OF THE UDC (UDC 7.1.7)
- 8) DURING THE DEVELOPMENT OF THE SITE, ANY INCREASE IN STORMWATER RUNOFF FLOW RATES MUST BE MITIGATED IN ACCORDANCE WITH UDC 8.2.8A, 8.2.B, AND IDM 3.05 RESULTING IN NO ADVERSE IMPACT BETWEEN EXISTING CONDITIONS AND PROPOSED CONDITIONS.

STATE OF TEXAS COUNTY OF NUECES

I, KARA SANDS, CLERK OF THE COUNTY COURT IN AND FOR NUECES COUNTY, TEXAS, DO HEREBY CERTIFY THAT THE FOREGOING INSTRUMENT DATED THE ____ DAY OF _____, 2025, WITH ITS CERTIFICATE OF AUTHENTICATION WAS FILED FOR RECORD IN MY OFFICE THE ____ DAY OF ____, 2025, AT ____ O'CLOCK ___ M. AND DULY RECORDED THE ____ DAY OF _____, 2025, AT ____ O'CLOCK ___ M., IN VOLUME ____, PAGE ____, MAP RECORDS NUECES COUNTY, TEXAS.

KARA SANDS, COUNTY CLERK NUECES COUNTY, TEXAS

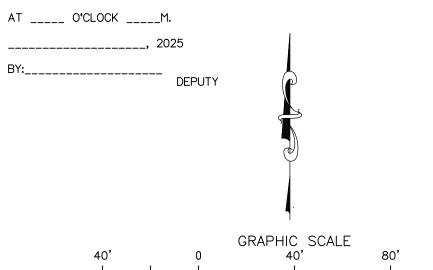

TEXAS GEO TECH LAND SURVEYING, INC

Scale: 1" = 40' feet

5525 S. STAPLES ST. SUITE B2 Corpus Christi, TX 78411 (361) 993-0808 Fax (361) 993-2955 JOB # 250613 JULY 14, 2025

120'